




Blue Tower

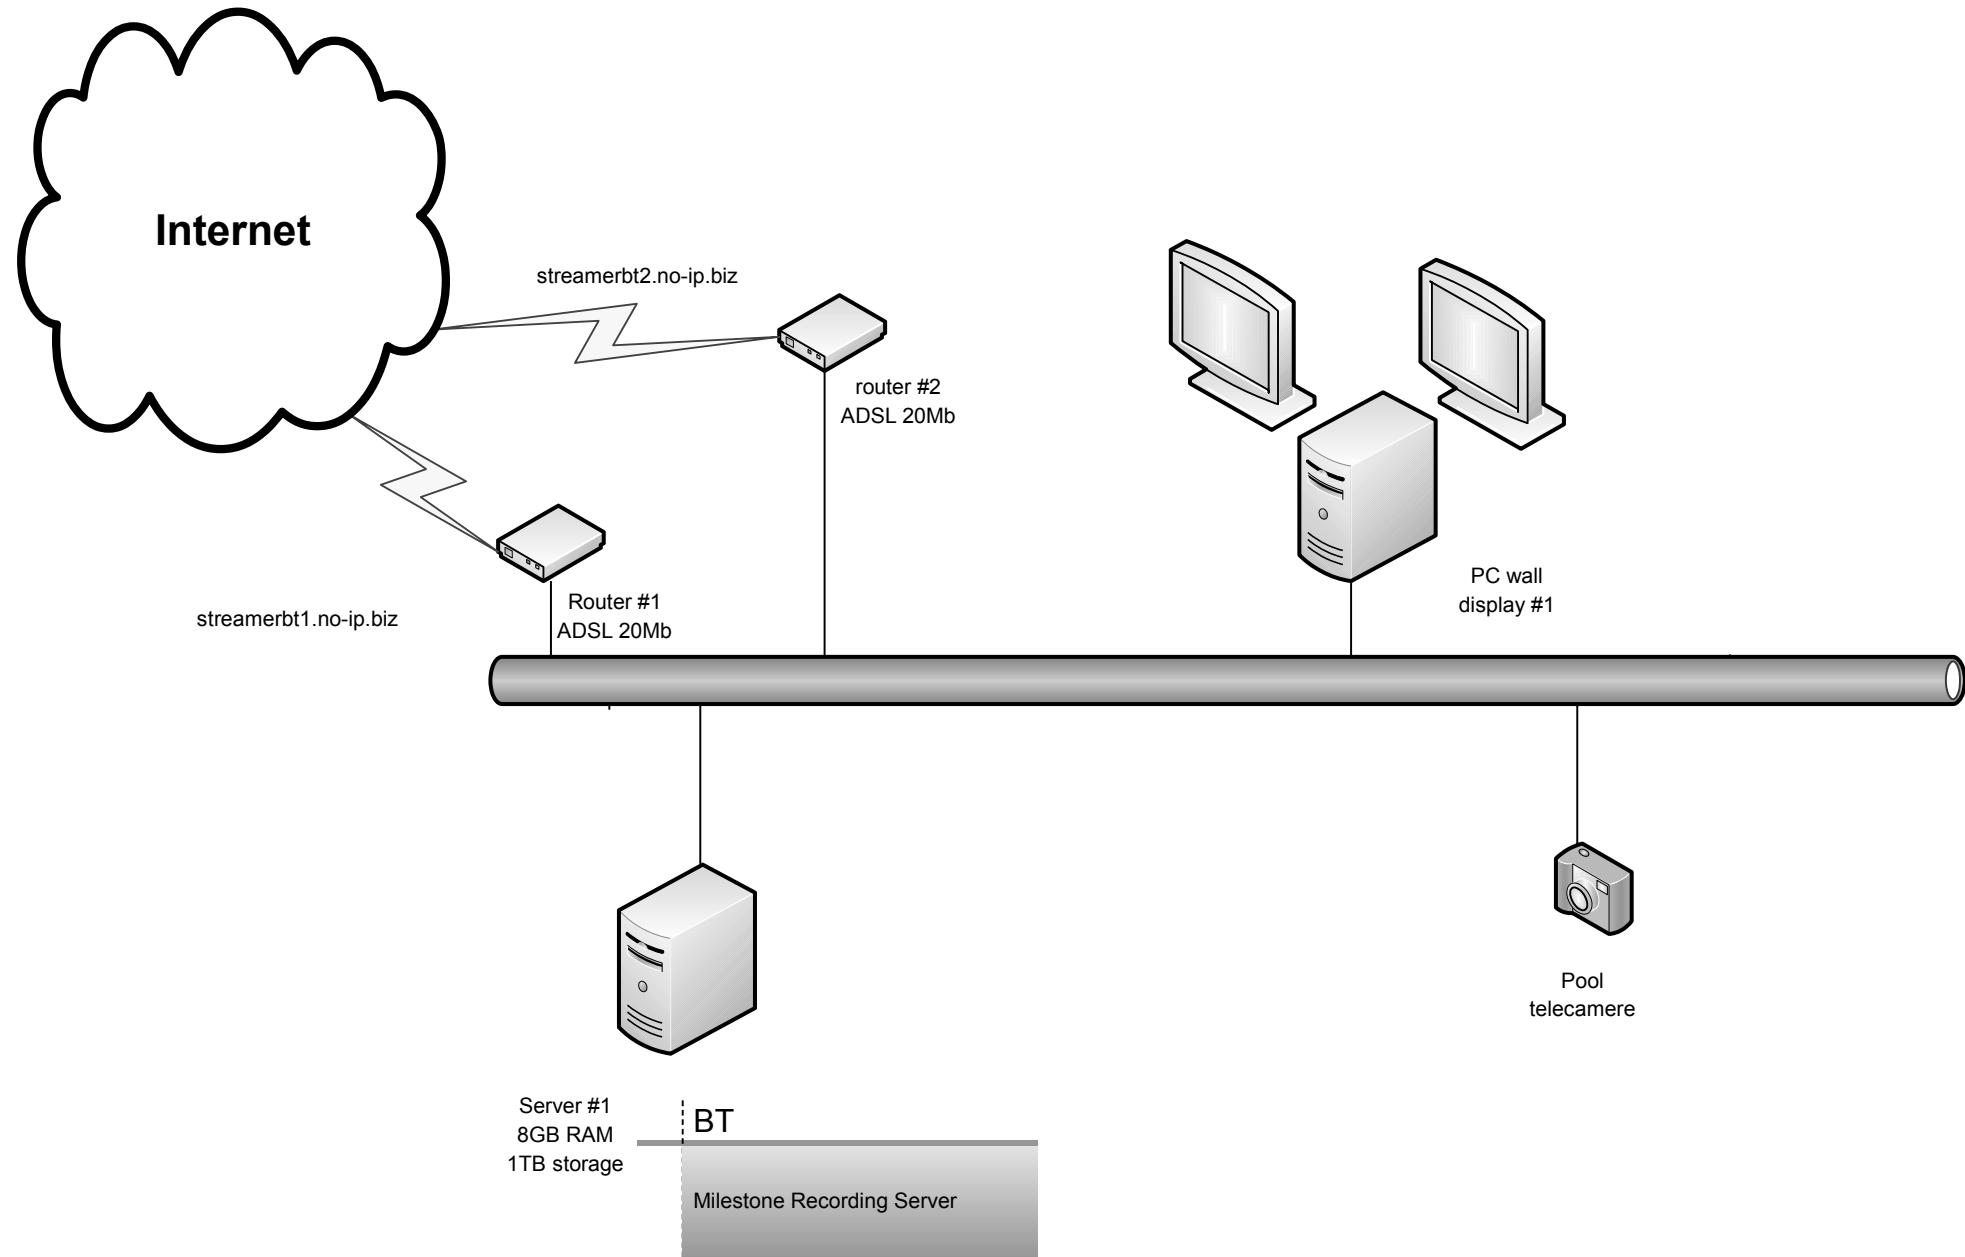

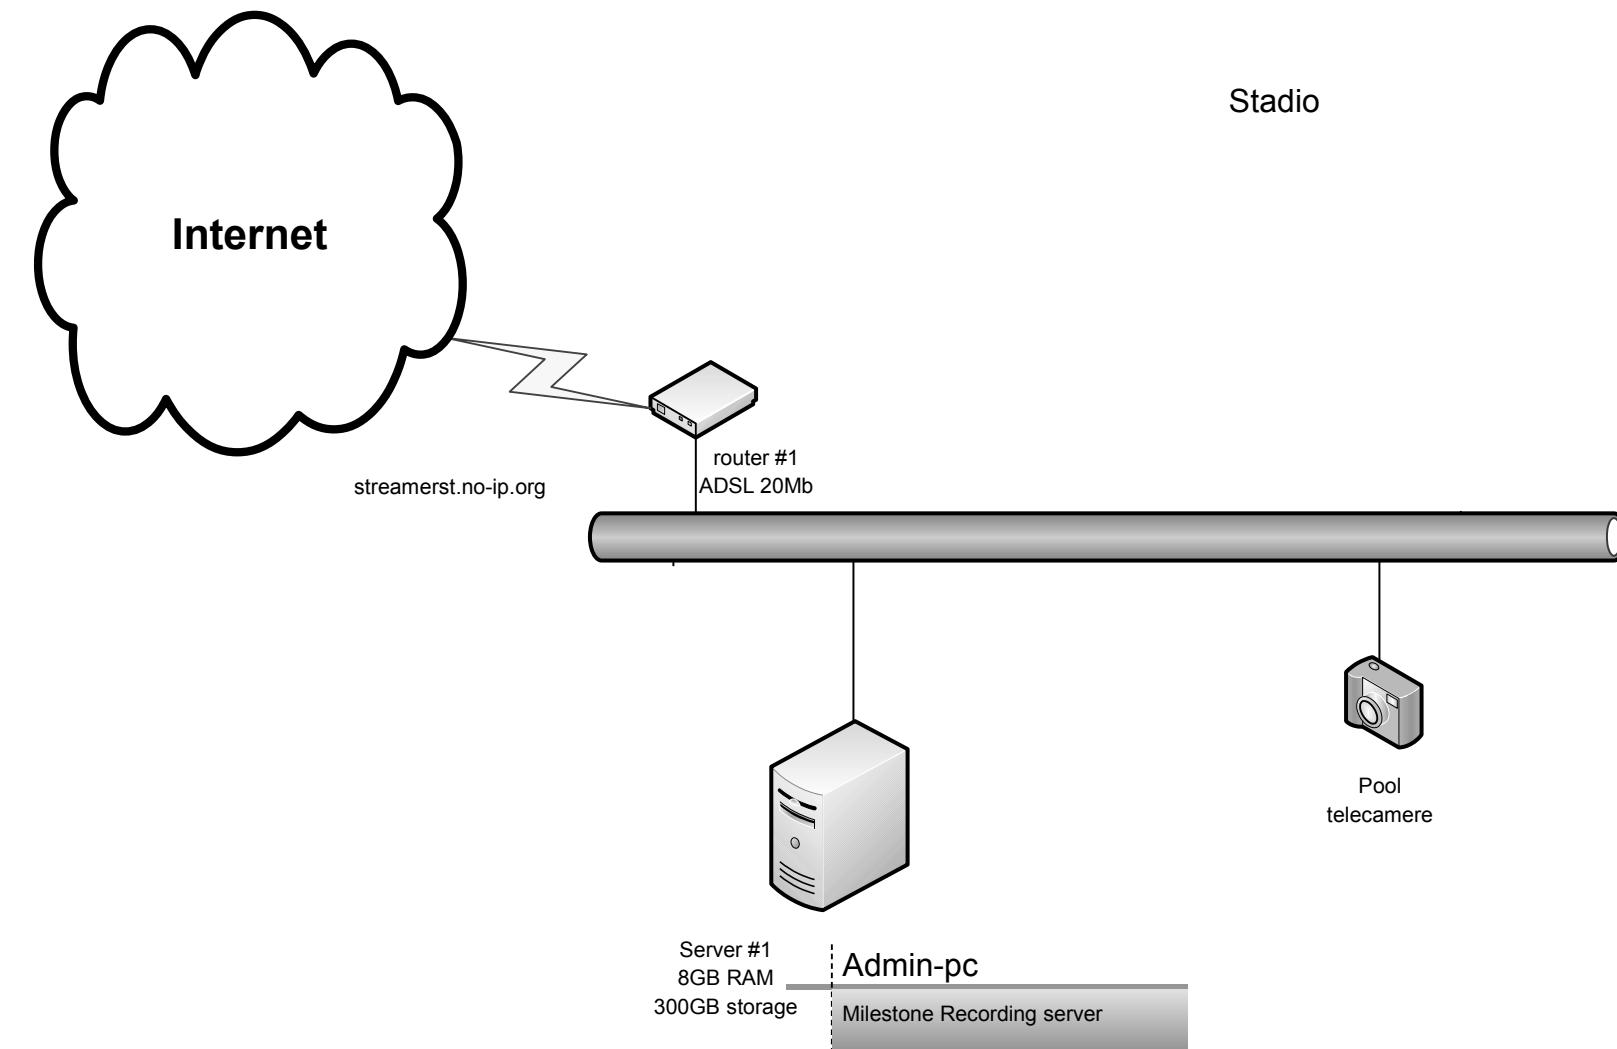

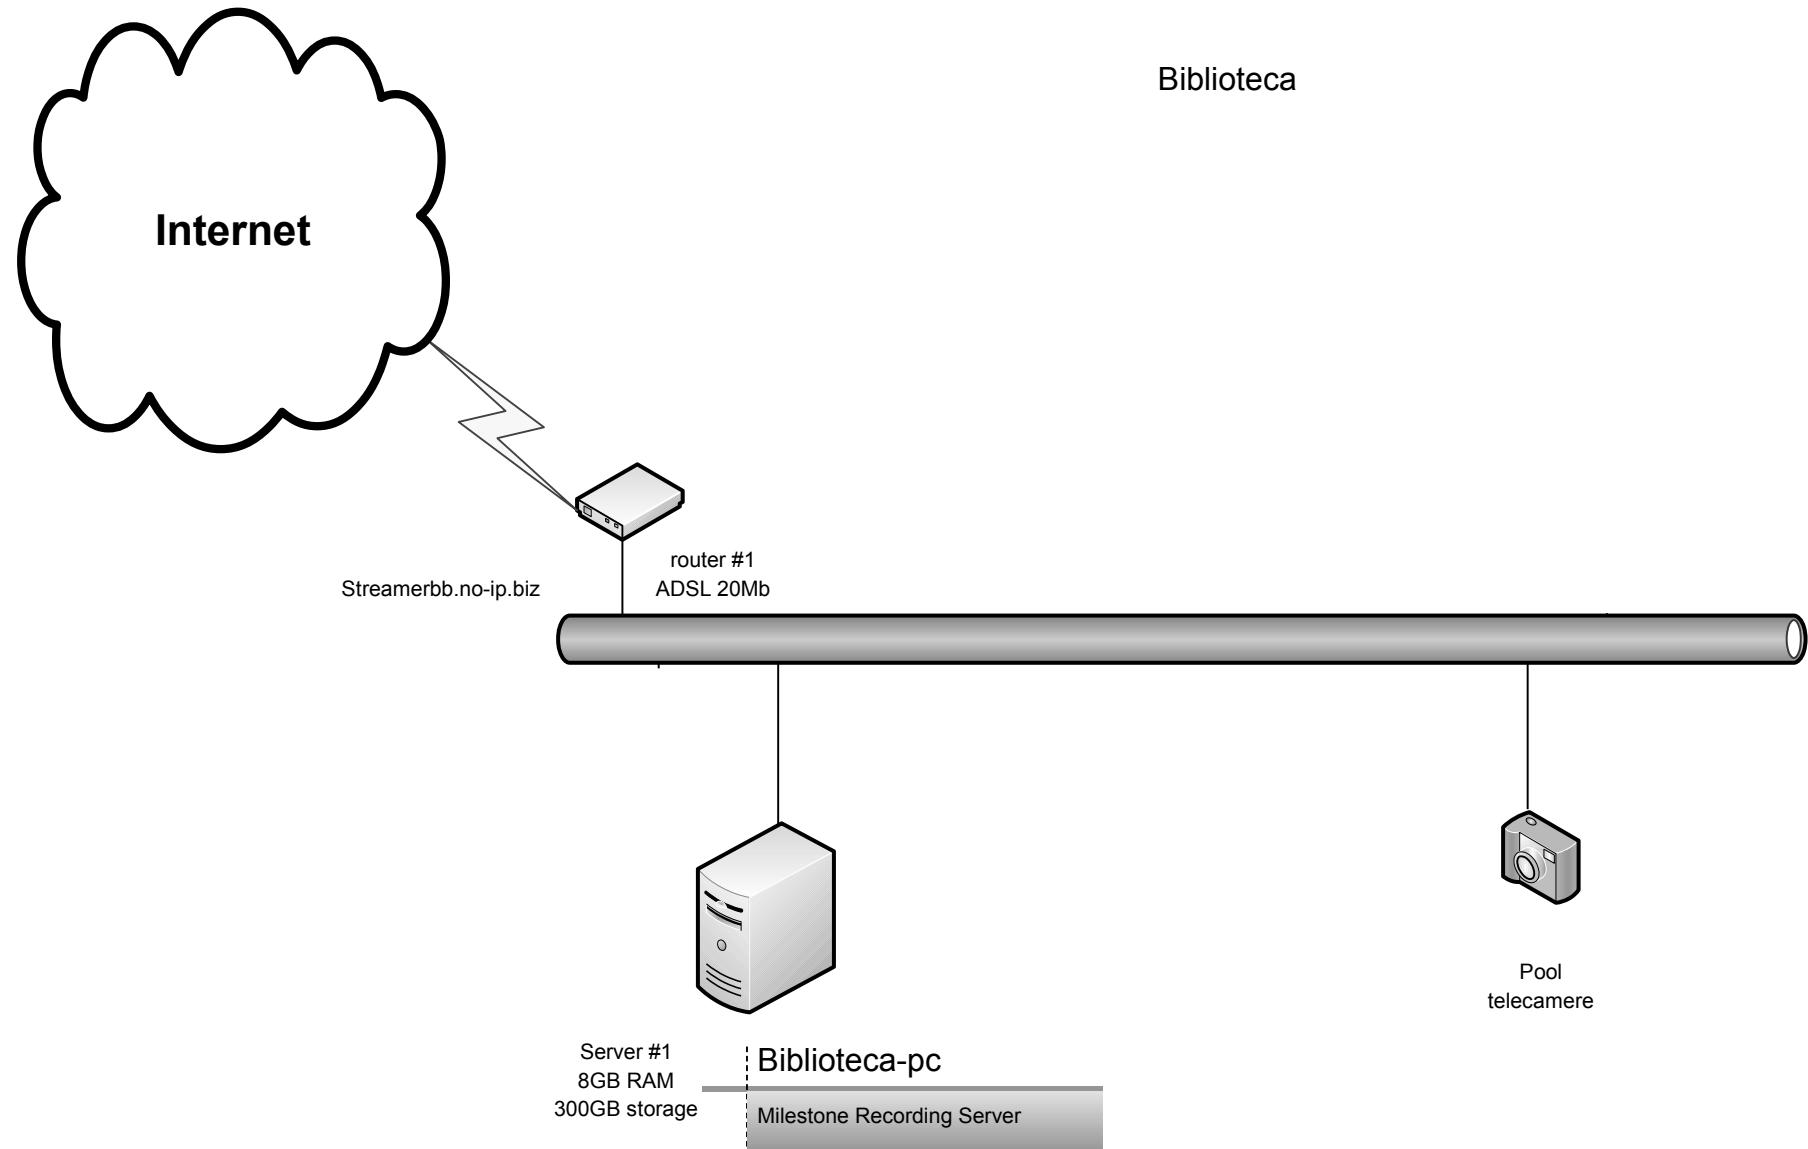

Questura

